DRAWING MADE IN THIRD ANGLE PROJECTION

LOC AF DIST 50

© COPYRIGHT 1979 BY AMP INCORPORATED, HARRISBURG, PA. ALL INTERNATIONAL RIGHTS RESERVED. AMP INCORPORATED PRODUCTS COVERED BY U. S. AND FOREIGN PATENTS AND/OR PATENTS PENDING.

| P | F | LTR. | DESCRIPTION | DATE | APP. |
|---|---|---|---|---|---|
| ✓ | ✓ | K | REVISED AF 0771 | 12/13/84 | JC/GY |
| ✓ | ✓ | L | OBS -3 AF-3157 | 8/22/88 | PmF/RRF |
| J | | M | ADD -4 PER AF-8059 | 8/31/92 | PmF |
| | | M1 | REVISED PER ECO-09-025273 | 16NOV09 | AEG |

REVISIONS

| P | F | ZONE | LTR | DESCRIPTION | DATE | APPROVED |
|---|---|---|---|---|---|---|
| ✓ | ✓ | | A | REVISED A-47 | 9/6/79 | SS / |
| ✓ | ✓ | | B | REVISED & RELEASED PER A-4441 | 1/9/80 | SS / RHM |
| ✓ | ✓ | | C | ADDED .25 A-47 | 1/13/80 | GY |
| ✓ | ✓ | | D | REVISED A-47 | 3/20/80 | JG |
| | | | E | REVISED A-47 | 6/3/80 | JG |
| ✓ | ✓ | | F | REVISED A-4711 | 7-7-80 | RLT/GY |
| ✓ | ✓ | | G | REVISED PER A-4746 | 8/15/80 | SS / GY |
| ✓ | ✓ | | H | REVISED PER A-5687 | 10/13/82 | SS / RGF |
| ✓ | ✓ | | J | ADDED -3 PER TTI-82/96 | 11/8/82 | SS / GY |

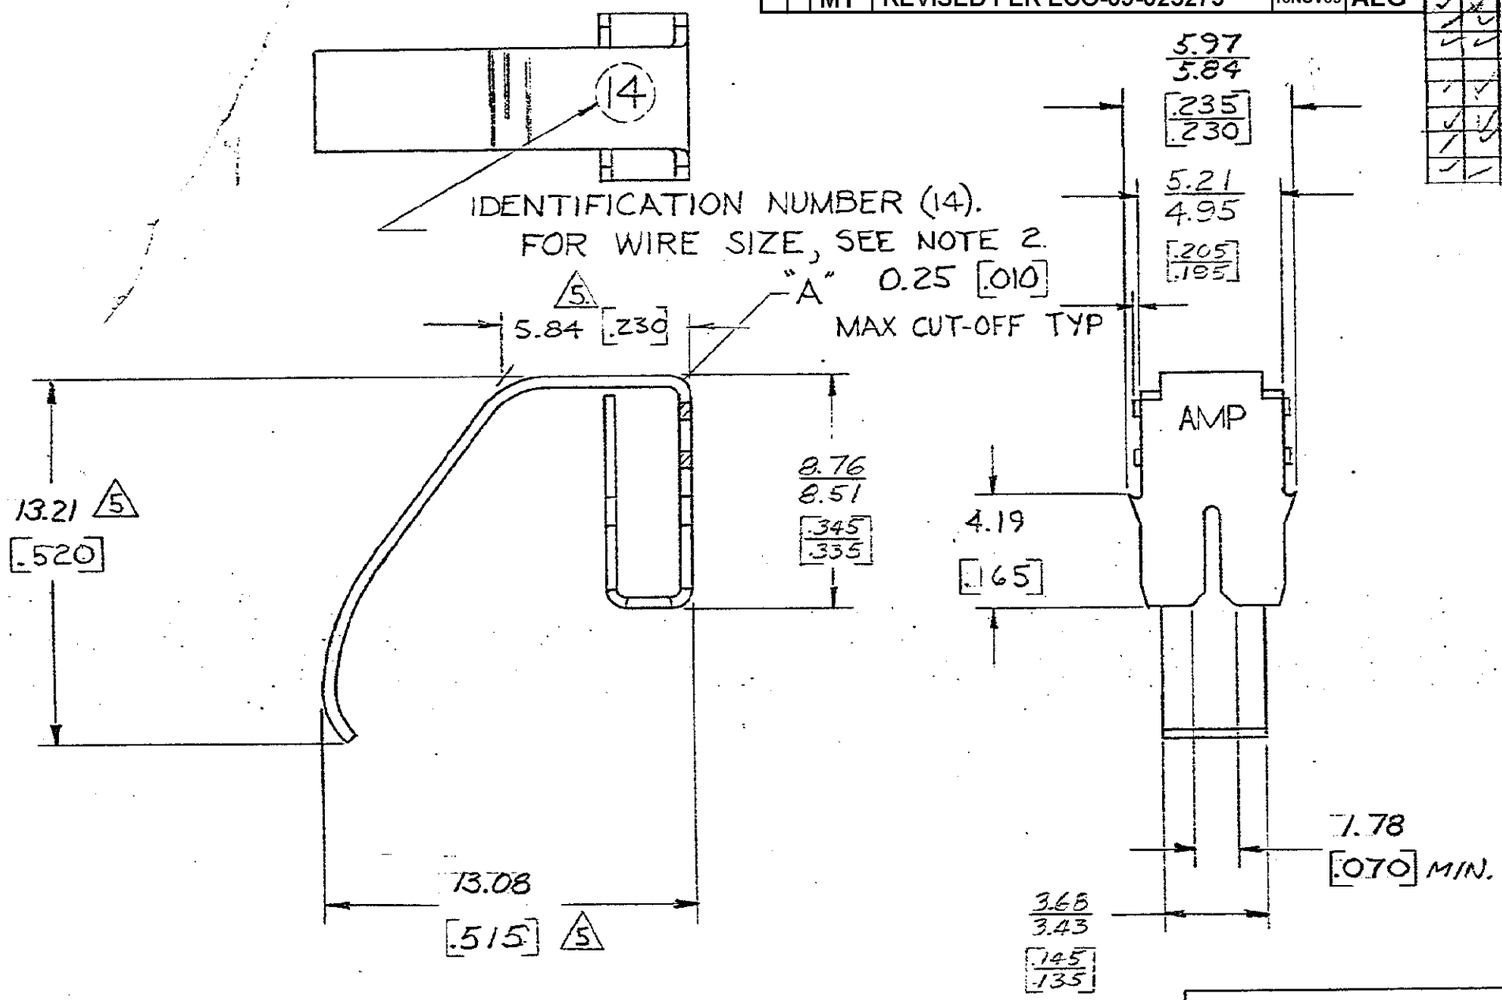


2. WIRE RANGE: 0.2 - 0.6 mm² [#24-20]
7 STRANDS OR SOLID,
INSULATION DIA: 1.78 [.070] MAX

3. FOR CAVITY DETAILS SEE APPLICATION SPECIFICATION 114-2044

4. RECOMMENDED BATTERY HOLDER SPECIFICATIONS:
A) "9" VOLT BATTERY - CP78-7721
B) "C" SIZE BATTERY - CP78-7926
C) "D" SIZE BATTERY - CP78-7875

5. THESE DIMENSIONS APPLY WHEN CORNER "A" IS FIXTURED AT 90°

6. SUPPLIED LOOSE PIECE

7. DIM'S IN BRACKETS ARE IN INCHES.

8. OBSOLETE PARTS: OBSOLETE CIS STREAMLINING PER D.RENAUD/D.SINISI

| | | |
|---|---|---|
| OBSOLETE | .000100 MIN BRIGHT NICKEL | ~~62879-4~~ |
| OBSOLETE | ~~BRIGHT TIN OVER NICKEL~~ | ~~62879-3~~ |
| 8 OBSOLETE | TIN | ~~62879-2~~ |
| | NONE | 62879-1 |
| | FINISH | PART NO |

METRIC

UNLESS OTHERWISE SPECIFIED DIMENSIONS ARE IN ~~INCHES~~ MM
TOLERANCES ON:
DECIMALS ±0.38 [.015]
ANGLES ±

MATERIAL 0.30 [.012] BRASS

FINISH SEE TABLE

CONTRACT NO
DR Steve Schaffhauser 3/16/79
CHK GY [illegible] 7/3/79
APPD D. W. Apicoll 7/3/79
APPD [illegible] 7/5/79
DSGN APPD
OTHER APPD

AMP INCORPORATED Harrisburg, Pa.

NAME UNIVERSAL BATTERY CONTACT

SIZE B | CODE IDENT NO 00779 | DRAWING NO 62879

SCALE | SHEET

AMP 1470-15 (7-73)

CUSTOMER DRAWING